

GENERAL NOTES

1. Only written dimension to be followed.
2. Any discrepancies should be referred to the architect.
3. This drawing & its copy right is the property of Studio AIRD.
4. It should not to be used, copied, traced or reproduced without their written permission.

REVISION

SIR. NO.	DESCRIPTION	DATE
----------	-------------	------

HYVAC, PLUM. & FF CONSULTANT

ELECTRICAL CONSULTANT

CLIENT

GFC TRACKER

DATE	REV. NO.	REV. DATE
------	----------	-----------

REVISION

PROJECT TITLE
---------------

GUPTA TOWER NAGPUR

DRAWING TITLE

FIXTURE LAYOUT

FIRST FLOOR

DRAWING NO.

ISSUED FOR

- ☐ INFORMATION ☒ APPROVAL
- ☐ COMMENTS ☐ TENDER
- ☐ EXECUTION ☐ AS-BUILT

DATE	SHEET. NO.	SCALE
08-08-2024	-	1:100
DRAWN BY	CHECK BY	APP. BY
D/PTI	SHL.PA	SATISH


FOR NORTH DIRECTION, PLEASE REFER SITE PLAN FOR ORIENTATION OF BUILDING



ARCHITECTURE • INTERIOR DESIGN • RETAIL DESIGN

Fairlink Center, A-305/306 Off New link Road

Andheri West, Mumbai, Maharashtra 400053

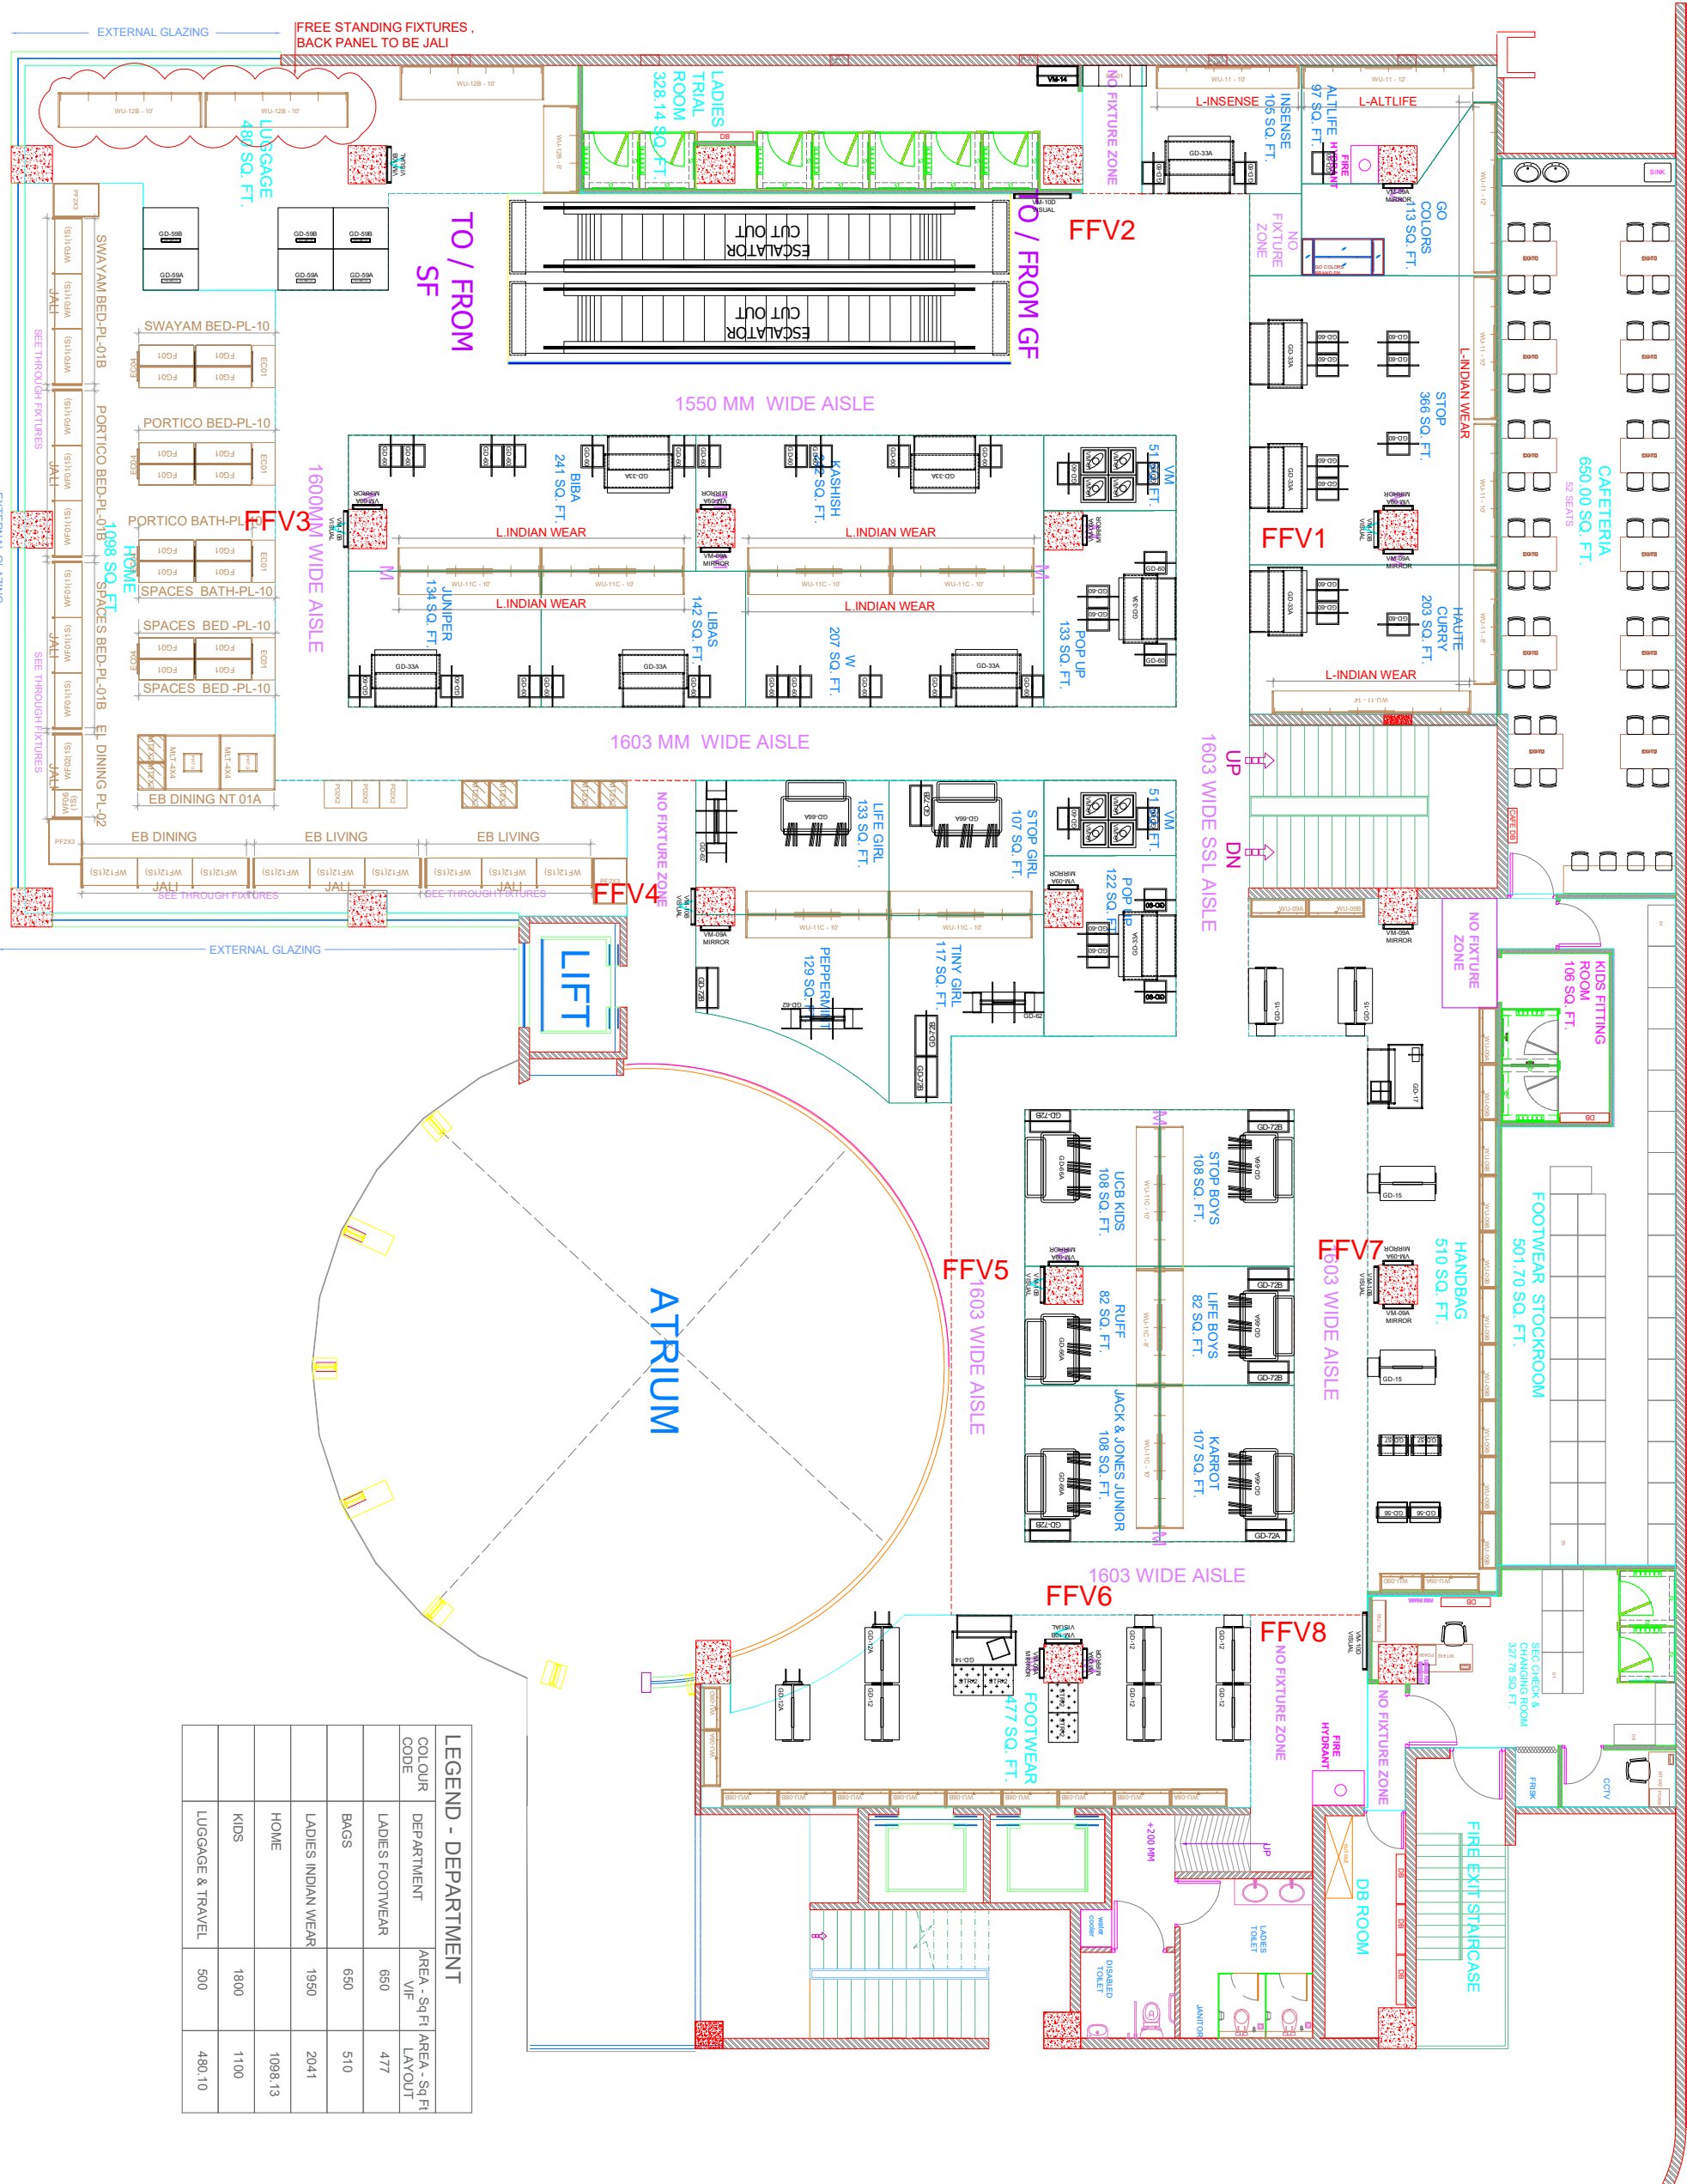

FIRST FLOOR FIXTURE LAYOUT

SCALE : 1:100